


Disegno per omologazione
Drawing for type-approval

Nota (-): vedere scheda informativa
Note (-): see information document


In **verde** particolari spostati.
In **rosso** particolari aggiunti o
modificati.

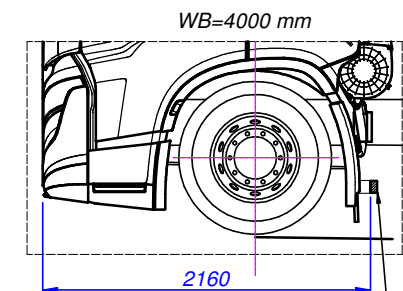


Luce e catadiottero laterale riposizionati
Side marker lamps and retro-reflecting
devices repositioned

Varianti: 1AS, 1AC e 2AC
Variants: 1AS, 1AC and 2AC


ST 3CF AA3C - Cab. AD/AT

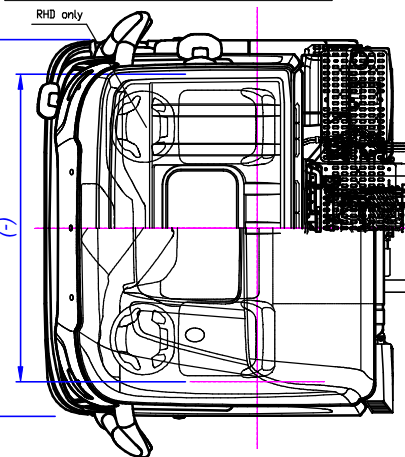

~~ST 3CF BA3C - Cab. AD/AT~~
~~Variants: 1AS~~

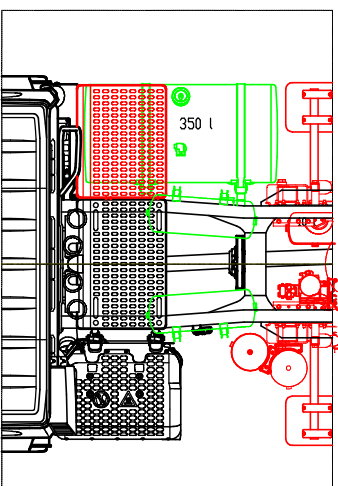


Varianti: 1AS
Variants: 1AS

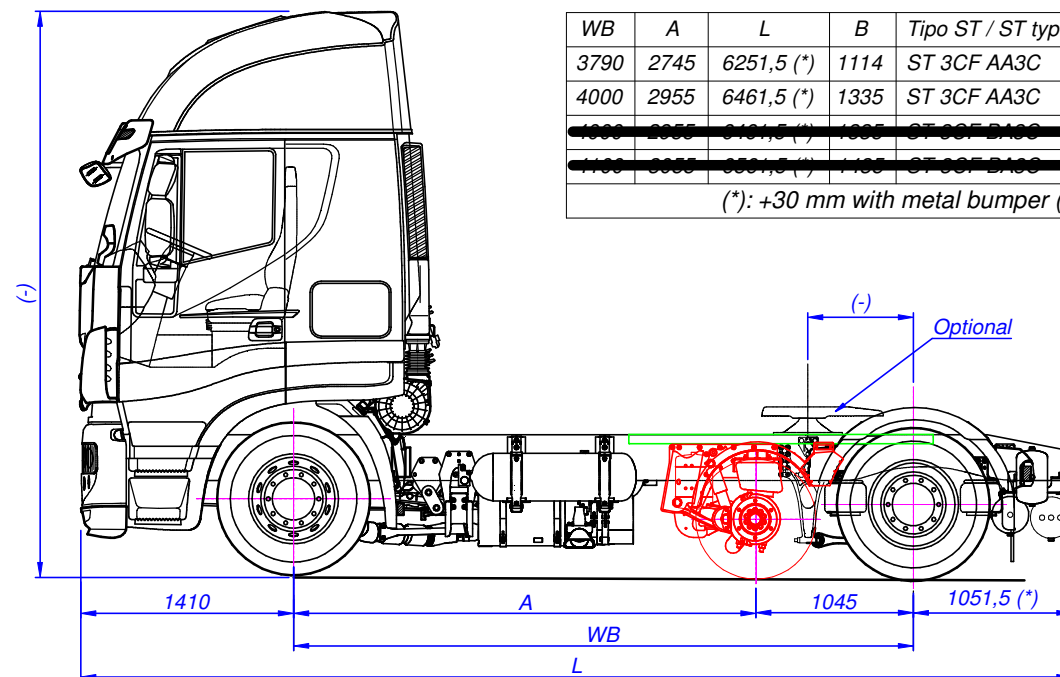

WB	A	L	B	Tipo ST / ST type	Var.
3790	2745	6251,5 (*)	1114	ST 3CF AA3C	1AS
4000	2955	6461,5 (*)	1335	ST 3CF AA3C	1AS
4000	2955	6461,5 (*)	1335	ST 3CF BA3C	1AS
4000	2955	6461,5 (*)	1335	ST 3CF BA3C	1AS

(*): +30 mm with metal bumper (optional)

~~Variants: CAC e 1AS~~
~~Variants: CAC and 1AS~~

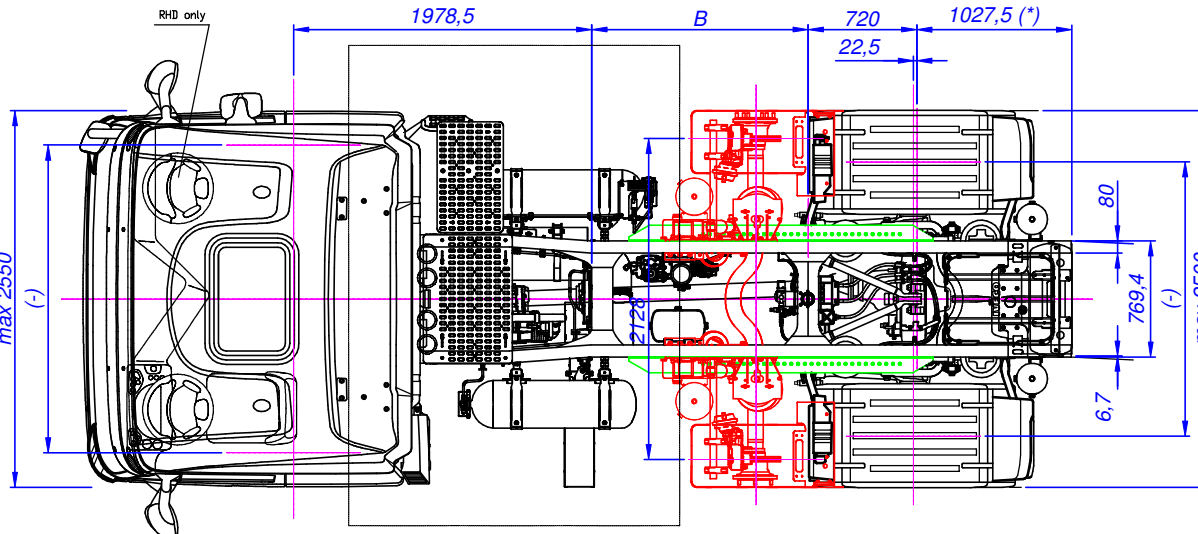

~~Variants: 22C~~
~~Variants: 22C~~

Rev. 3 del 12.10.2020 aggiunto passo 3790 mm per tipo ST 3CF AA3C
Rev. 2 del 29.07.2020 aggiunta tabella parametrica per passi 4000 e 4100 mm
Rev. 1 del 07.11.2019 aggiunta nuova cabina (nuove varianti)

Tightening Tolerance 1004	ISO 2768 - ---- Tolerancing ISO 8015	Author F. MARTINI	Date 18/05/2019	Scale 1:25
All proprietary rights reserved by S.T. Sychem Truck S.p.A. The reproduction, distribution and all rights of this document are reserved to S.T. Sychem Truck S.p.A. It is prohibited to use this document without the express authorization of S.T. Sychem Truck S.p.A.				
Description FIGURINO VEICOLO IVECO STRALIS BA3C CNG o AA3C GASOLIO CON ASSALE CENTRALE 4.5T 17.5" Passo 3790 mm, 3800 mm oppure da 3800 a 4000 o 4100 mm				
Code 55.01.02.0094	Drawing 55.01.02.0094	Sheet 1/1	Formal A2	